


E: 66747.9330(m)

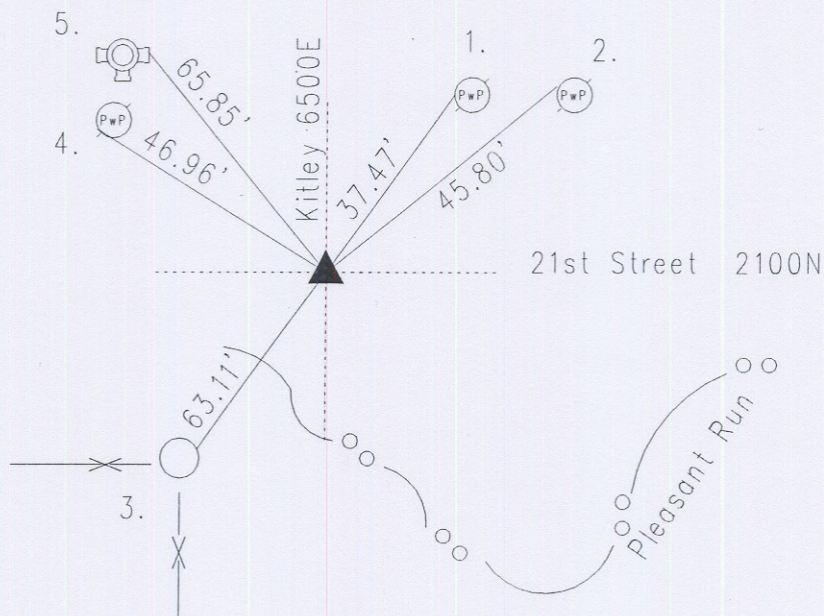

Corner History: Original post set 1820 by Laughlin with witness: 10" ash S 72 E 19 links; 8" white oak S 86 W 11 links per Marion County Atlas pg. 11. Records per 3"x5" tie cards; reference by Woerner 6-18-48 called drilled hole. Reference by Monroe dated 7-12-51 called cut cross. Reference by Wilcoxen dated 2-24-76 called Cut 'x' in concrete. Reference by Wilcoxen dated 1-22-87 called cut 'x' found in concrete. Reference by Kiste dated 7-7-1999 called cut 'x' found in concrete. Reference by Wilcoxen dated 9-1-05 called same. Reference by Wilcoxen dated 10-29-08 found brass plug SW 1.10. Set Harrison per ties & GPS coordinates, no other points were found.

16043502

REF.	DISTANCE	DESCRIPTION
1.	37.47'	Road nail W PwP#246-477A 12"up
2.	45.80'	Road nail W PwP#1-477A 12"up
3.	63.11'	Face of corner steel fence post 48" up
4.	46.96'	Road nail SW PwP#186-476A 10"up
5.	65.85'	Cut 'x' F-flange of fire hydrant